

#3

EXP MAIL NO. EV064993128US

PATENT



IN THE UNITED STATES PATENT AND TRADEMARK OFFICE

Applicants : Jon W. Brown et al.  
Application No. : 09/955,750  
Filed : September 18, 2001  
For : METHODS AND SYSTEMS FOR DYNAMICALLY SERVING IN-STREAM ADVERTISEMENTS

Art Unit : 2681  
Docket No. : 100105.401  
Date : January 24, 2002


Box Missing Parts  
Commissioner for Patents  
Washington, DC 20231

REQUEST FOR DRAWING CHANGE

Commissioner for Patents:

Drawing changes, as indicated in red on the attached drawing, are hereby submitted for approval by the Examiner. These changes do not constitute new matter. Also enclosed is a complete set of the formal drawings.

Respectfully submitted,  
Jon W. Brown et al.  
Seed Intellectual Property Law Group PLLC

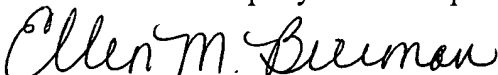  
Ellen M. Bierman  
Registration No. 38,079

EMB:asl

Enclosures:

Postcard  
Redlined Figure 10  
Formal Drawings

701 Fifth Avenue, Suite 6300  
Seattle, Washington 98104-7092  
Phone: (206) 622-4900  
Fax: (206) 682-6031

D:\NrPortbl\iManage\ANGIEL\251779\_1.DOC

20020124 13:55:00

#3

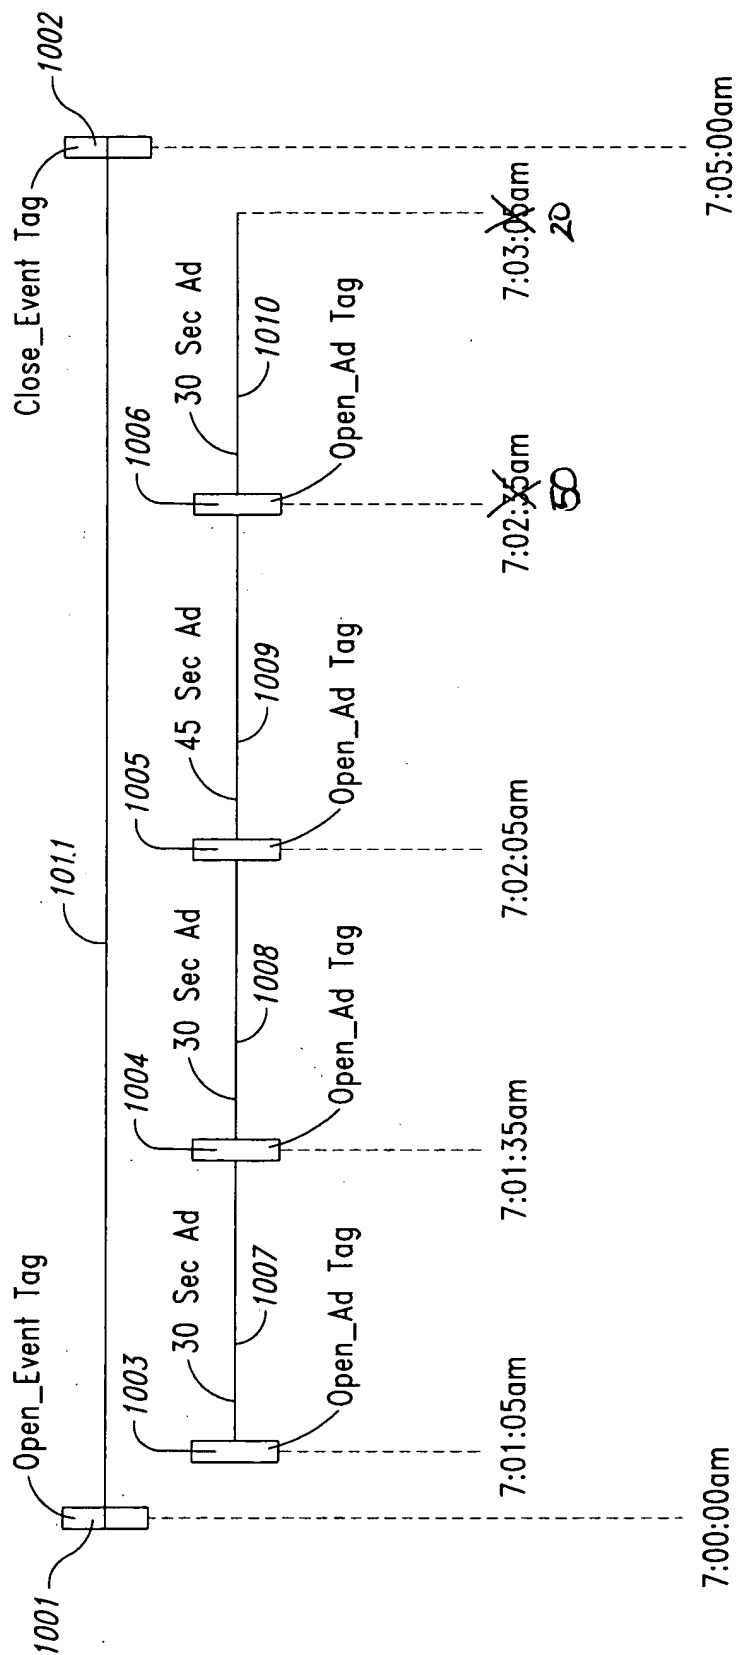


Fig. 10